



**A** STAIR SECTION  
SCALE: 1/8" = 1'-0"

D:\CAD\0314

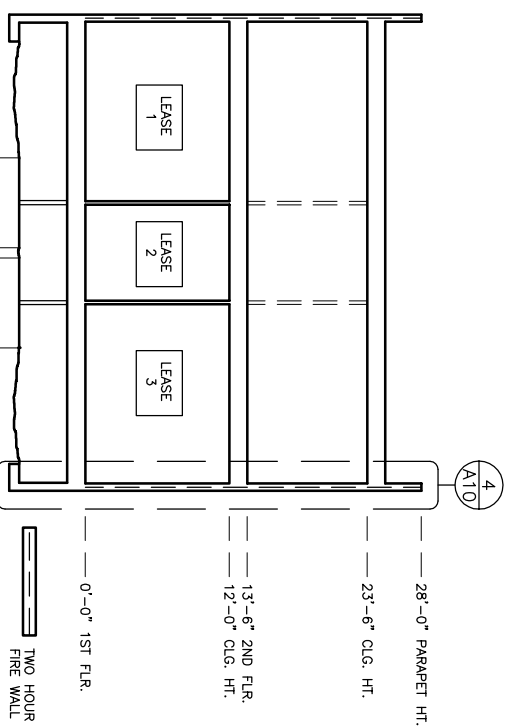


**B** BUILDING SECTION  
SCALE: 1/8" = 1'-0"

D:\CAD\0314

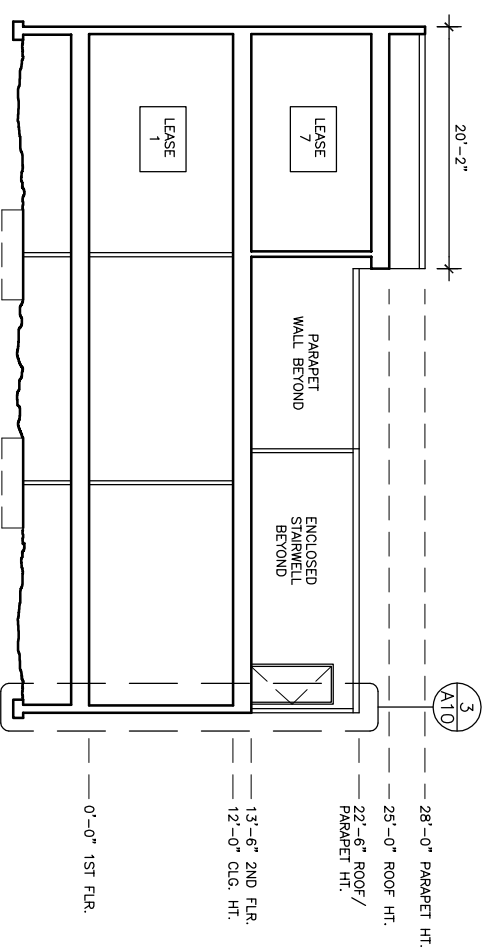

**C** BUILDING SECTION  
SCALE: 1/8" = 1'-0"

D:\CAD\0314

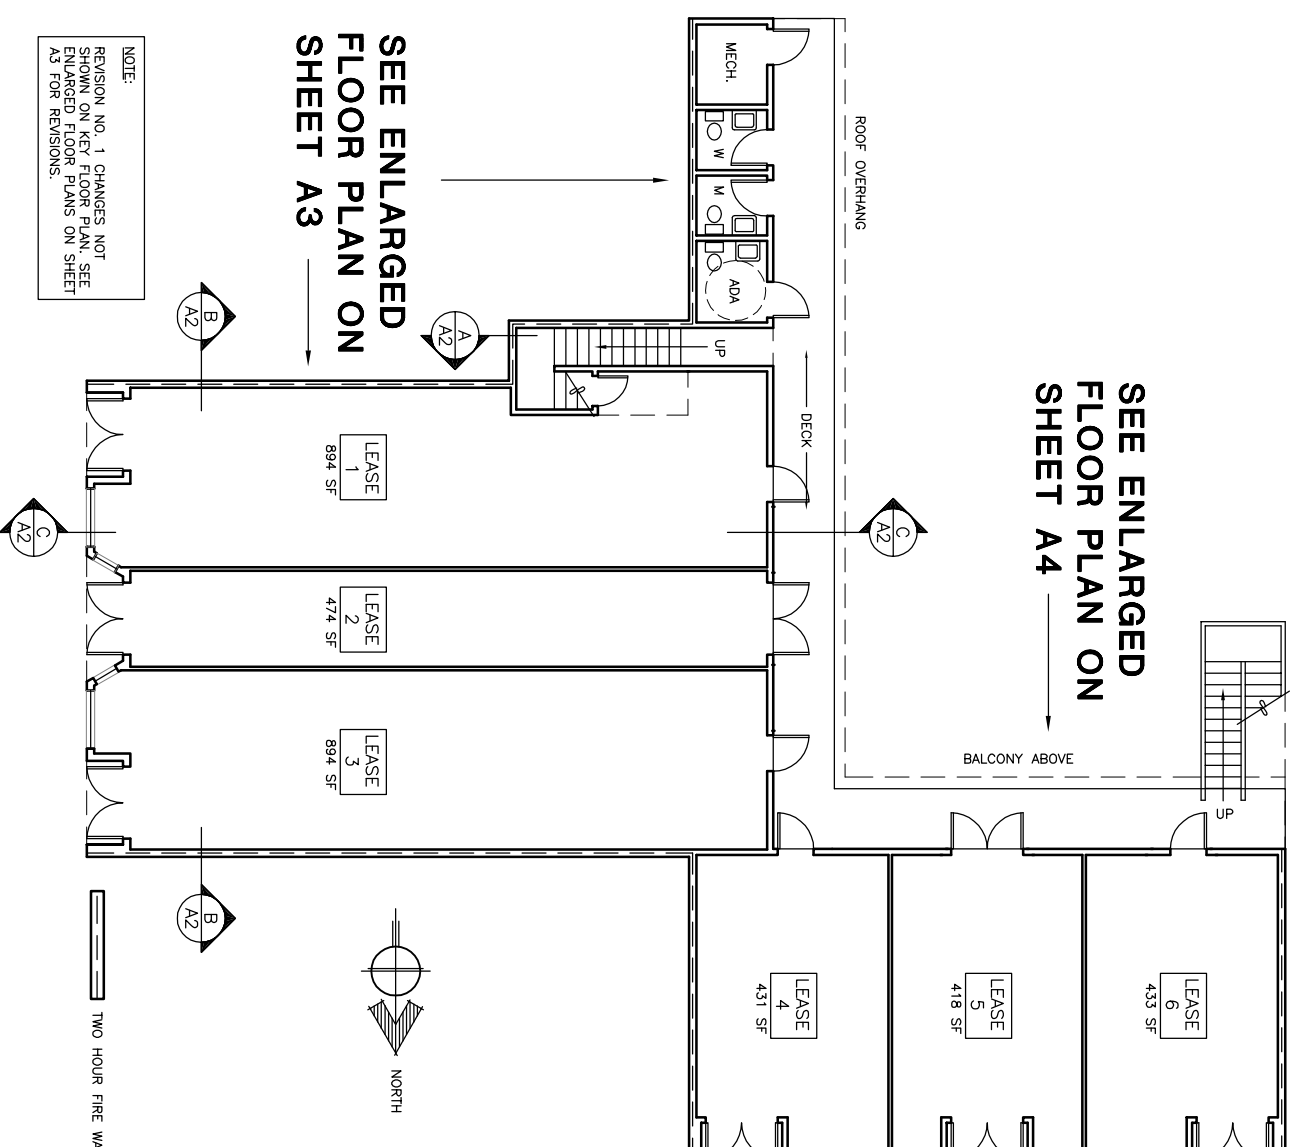


**D** KEY FLOOR PLAN  
SCALE: 1/8" = 1'-0"

D:\CAD\0314

CONSTRUCTION DOCUMENTS

SKAGWAY BAZAAR BUILDING

6th Avenue & Broadway  
Skagway, Alaska 99840

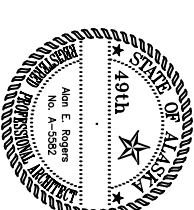

AK Fire Marshal Review No. 2004-0057

**A.E. Rogers**  
ARCHITECTS, L.L.C.  
P.O. Box 34401 • Juneau, Alaska 99803  
Tele 907.789.7589 Fax 907.789.1638

REVISION NO. 1 NOTES:  
REVISION NO. 1 CONSISTS OF DESIGN & CONSTRUCTION CHANGES TO THE BUILDING BY THE OWNER.

Number	Date	By	Description of Revision
1	7-10-04	OWNER	AS-BUILT

Sheet Title  
**KEY FLOOR PLAN**  
BLDG. SECTIONS

Scale AS SHOWN (HALF SCALE AT 11X17)  
Designed AER Drawn AER  
Date MARCH 18, 2004 Checked AER  
Approved By AER Job Number 0314

Sheet Number

