

AK Fire Marshal Review No. 2004-0057

CONSTRUCTION DOCUMENTS
SKAGWAY BAZAAR BUILDING

6th Avenue & Broadway
 Skagway, Alaska 99840

REVISION NO. 1 NOTES:
 REVISION NO. 1 CONSISTS OF
 DESIGN & CONSTRUCTION CHANGES
 TO THE BUILDING BY THE OWNER.

Number	Date	By	Description of Revision
1	7-10-04	OWNER	AS-BUILT

Sheet Title
**ENLARGED
 FLOOR PLAN**

Scale AS SHOWN (HALF SCALE AT 11X17)

Designed AER Drawn AER


Date MARCH 18, 2004 Checked AER

Approved By AER Job Number 0314


Sheet Number

A4

OF 11

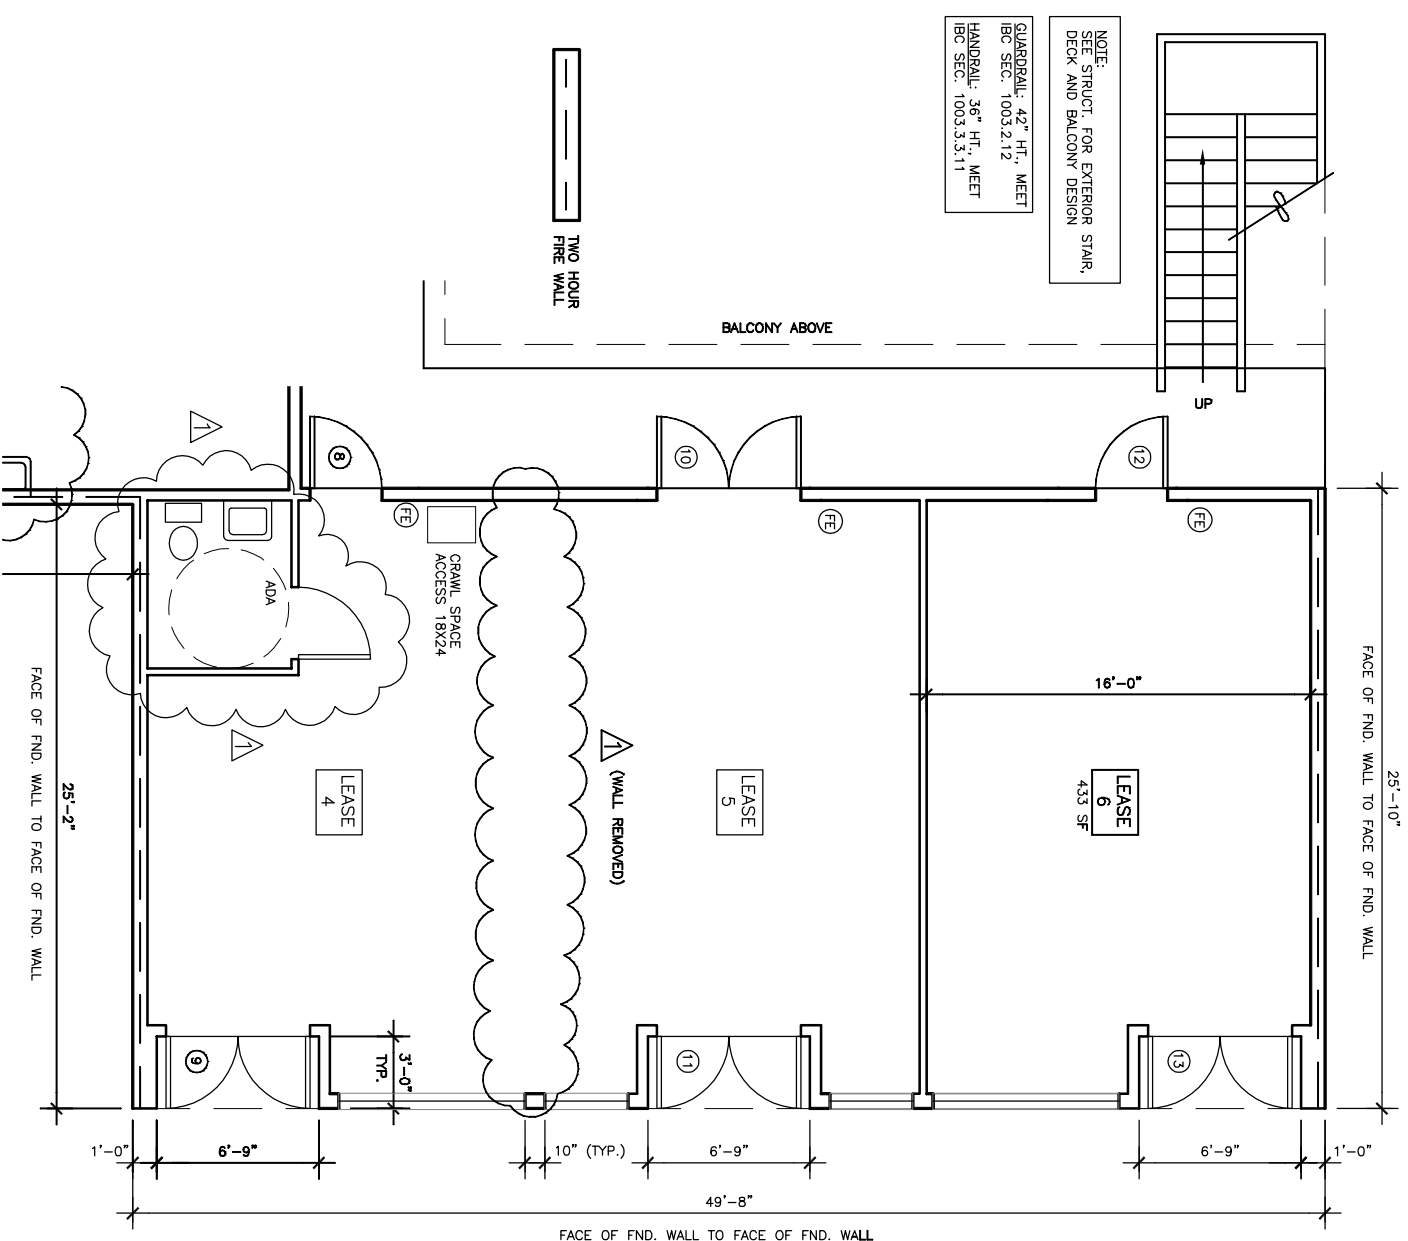

B PHASE 2 - 1ST FLR. PLAN
 SCALE: 1/4" = 1'-0"
 D:\CAD\0314

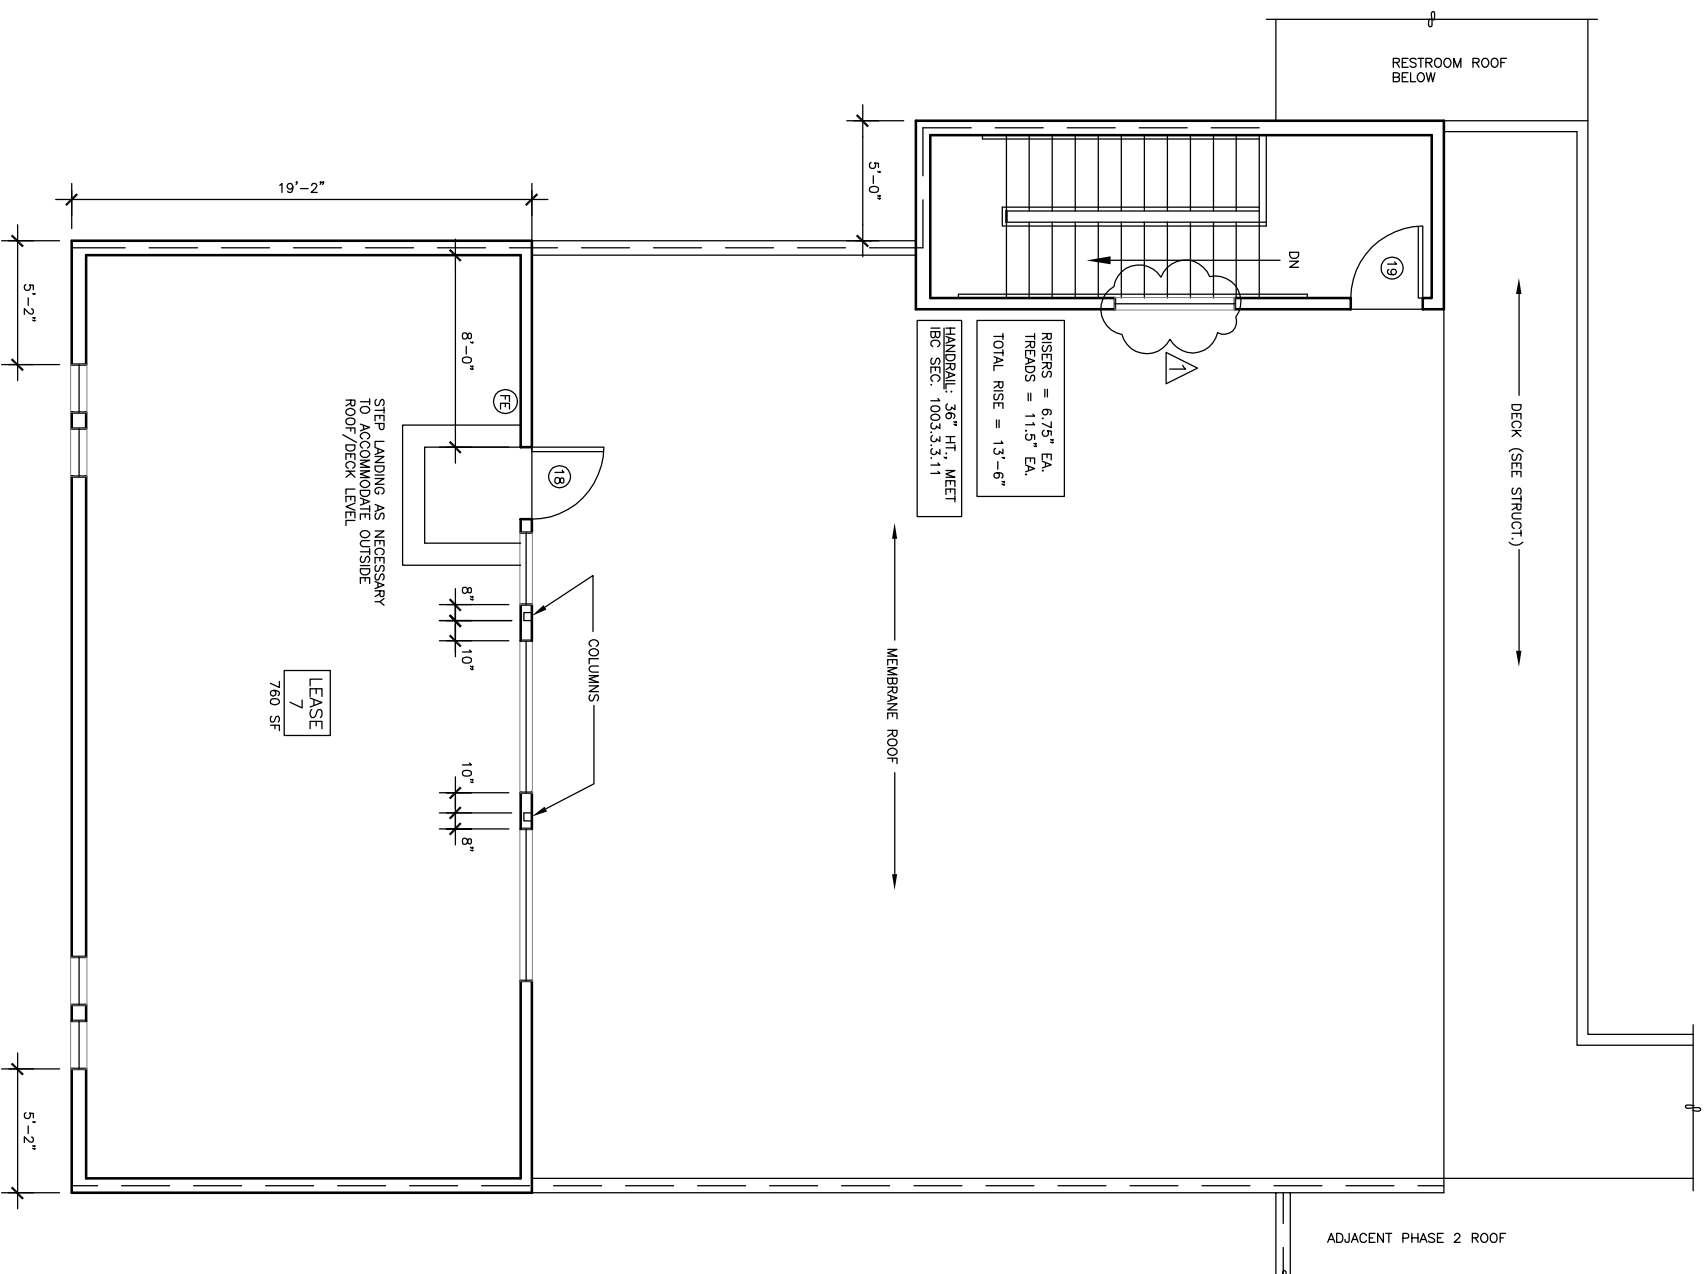

A PHASE 1 - 2ND FLR. PLAN
 SCALE: 1/4" = 1'-0"
 D:\CAD\0314

